

Date: Wednesday, 1/18/2006 4:05:35 PM
 User: Kim Johnston

Process Sheet

Customer	: CU-DAR001 Dart Helicopters Services	Drawing Name	: BRACKET ASSEMBLY
Job Number	: 25557D		
Estimate Number	: 10291		
P.O. Number	: <i>NIA</i>	Part Number	: D3183044
This Issue	: 1/18/2006 S.O. No. : <i>NIA</i>	Drawing Number	: D3183 REV C1
Prsht Rev.	: NC	Project Number	: N/A
First Issue	: <i>NIA</i> Type : MACHINED PARTS	Drawing Revision	: C1
Previous Run	: 25442D	Material	: <i>NIA</i>
Written By	: <i>SEE COMMENT BELOW</i>	Due Date	: 2/15/2006
Checked & Approved By	: <i>SEE COMMENT BELOW</i>	Qty:	4 Um: Each
Comment	: Est Rev: Pick: A 04.02.18 New issue KJ/DS		

Additional Product

Job Number:



Seq. #:	Machine Or Operation:	Description :
---------	-----------------------	---------------

1.0	M174B2000X01500	17-4 SS Bar
-----	-----------------	-------------



Comment: Qty.: 0.4812 f(s)/Unit Total: 1.9249 f(s)
 Material: 17-4 SS Bar per AMS 5604/5643
 (M17-4-B1.500x02.000)
 Identify for D3183-~~044~~ - 4
 Batch: *M14773*

MS 06/02/06 4

2.0	BAND SAW	BAND SAW
-----	----------	----------



Comment: BAND SAW *1.50*
 Cut blanks: (~~1.000~~ x 2.000") 5.500" long

MS 06/02/06 4

3.0	HAAS1	HAAS CNC VERTICAL MACHINING #1
-----	-------	--------------------------------



Comment: HAAS CNC VERTICAL MACHINING #1

1-Machine D3183-4 as per Folio FA322 and Dwg D3183
 Identify as D3183-4

SA/MS 06/02/06 4

2-Deburr

SA/MS 06/02/06

3-Scribe batch number

SA/MS 06/02/06

4.0	QC2	INSPECT PARTS AS THEY COME OFF MACHINE
-----	-----	--



Comment: INSPECT PARTS AS THEY COME OFF MACHINE

SA/MS 06/02/06 4

W/O:		WORK ORDER CHANGES					
DATE	STEP	PROCEDURE CHANGE	By	Date	Qty	Approval Chief Eng / Prod Mgr	Approval QC Inspector

Part No: _____ PAR #: _____ Fault Category: _____ NCR: Yes ☒ No ☐ DQA: ☒ Date: 26/07/07

QA: N/C Closed: _____ Date: _____

NCR:		WORK ORDER NON-CONFORMANCE (NCR)						
DATE	STEP	Description of NC Section A	Corrective Action Section B			Verification Section C	Approval Chief Eng	Approval QC Inspector
			Initial Chief Eng	Action Description Chief Eng	Sign & Date			

NOTE: Date & initial all entries

Date: Wednesday, 1/18/2006 4:05:36 PM
User: Kim Johnston

Process Sheet

Customer: CU-DAR001 Dart Helicopters Services

Drawing Name: BRACKET ASSEMBLY

Job Number: 25557D

Part Number: D3183044

Job Number:



Seq. #:

Machine Or Operation:

Description :

5.0

QC8

SECOND CHECK



Comment: SECOND CHECK

B6 06.02.07

4

6.0

D312121

Bolt



Comment: Qty.: 2.0000 Each(s)/Unit Total : 8.0000 Each(s)

Pick:

Qty Part Number Description Batch

2 D3121-21 Bolt B 25456

B6 06.02.07

7.0

D3183045

Bearing Assembly



Comment: Qty.: 2.0000 Each(s)/Unit Total : 8.0000 Each(s)

Pick:

Qty Part Number Description Batch

2 D3183-045 Bearing Ass B 23974

B6 06.02.07

8.0

SMALL FAB 1

SMALL & MEDIUM FAB RESOURCE 1



Comment: SMALL & MEDIUM FAB RESOURCE 1

Assemble D3183-043 as per Dwg D3183.

B6 06.02.07

4

9.0

QC5

INSPECT WORK TO CURRENT STEP



Comment: INSPECT WORK TO CURRENT STEP

B6 06.02.07

4

10.0

PACKAGING 1

PACKAGING RESOURCE #1



Comment: PACKAGING RESOURCE #1

Identify and Stock

Location: _____

16/2/8 (4)

11.0

DC

DOCUMENT CONTROL



Comment: DOCUMENT CONTROL

Inspection Level 21

5.5 06/02/09

(4)

Q

06/02/09

Job Completion



W/O:		WORK ORDER CHANGES					
DATE	STEP	PROCEDURE CHANGE	By	Date	Qty	Approval Chief Eng / Prod Mgr	Approval QC Inspector

Part No: _____ PAR #: _____ Fault Category: _____ NCR: Yes No DQA: _____ Date: _____

QA: N/C Closed: _____ Date: _____

NCR:		WORK ORDER NON-CONFORMANCE (NCR)						
DATE	STEP	Description of NC Section A	Corrective Action Section B			Verification Section C	Approval Chief Eng	Approval QC Inspector
			Initial Chief Eng	Action Description Chief Eng	Sign & Date			

NOTE: Date & initial all entries

DART AEROSPACE LTD		Work Order:	25557D
Description: Bracket		Part Number:	D3183-4
Inspection Dwg: D3183	Rev: C	Page 1 of 1	

FIRST ARTICLE INSPECTION CHECKLIST

☒ First Article ☐ Prototype

Drawing Dimension	Tolerance	Actual Dimension	Accept	Reject	Method of Inspection	Comments
R0.190	+/-0.030					
R0.063	+/-0.010					
0.182	+/-0.010					
0.070	+/-0.010					
0.100	+/-0.010					
Ø0.201 x 0.100	+/-0.010					
0.182	+/-0.010					
5.32	+/-0.030					
5.036	+/-0.010					
2.120	+/-0.010					
1.290	+/-0.010					
0.365	+/-0.010					
0.218	+/-0.010					
1.030	+/-0.010					
1.90	+/-0.030					
1.012	+/-0.010					
Ø0.201 x 0.100	+/-0.010					
0.182	+/-0.010					
0.786	+/-0.010					
Ø0.392	+0.002/-0.000					
R0.19	+/-0.030					
3.954	+/-0.010					
0.162	+/-0.010					
R0.19	+/-0.030					
R0.25	+/-0.030					
4.26	+/-0.030					
2.800	+/-0.030					
Calculated dimension						
0.162	+/-0.010					
0.615	+/-0.010					
0.435	+/-0.010					
0.200	+/-0.010					
0.381	+/-0.010					
0.032	+/-0.010					

Same as 25442D
MS
(same setup & ran at same time)


Measured by:		Audited by:	BG	Prototype Approval:	N/A
Date:		Date:	06.02.07	Date:	N/A

Rev	Date	Change	Revised by	Approved
A	03.11.12	New Issue P/O D3183-044	KJ/RF	
B	04.03.15	Changes as per revision C	KJ/JLM/RF	
C	04.06.15	Dimension 2.800 was 2.080; removed 1.155, 0.36 dimensions	KJ/JLM	




DESIGN #	DRAWN BY CP	DART AEROSPACE LTD HAWKESBURY, ONTARIO, CANADA	
CHECKED #	APPROVED #	DRAWING NO. D3183	REV. C SHEET 1 OF 4
DATE 04.02.17		TITLE BRACKET ASSEMBLY	SCALE 1:1
A	03.01.24	NEW ISSUE	
B	03.06.17	REMOVE BEARING; 1.012 WS 0.882	
C	04.02.17	ADD -045/-9; 0.182 WAS 0.431	
CI	04.11.09	0.830 WAS 0.850	

RELEASED
04.03.01

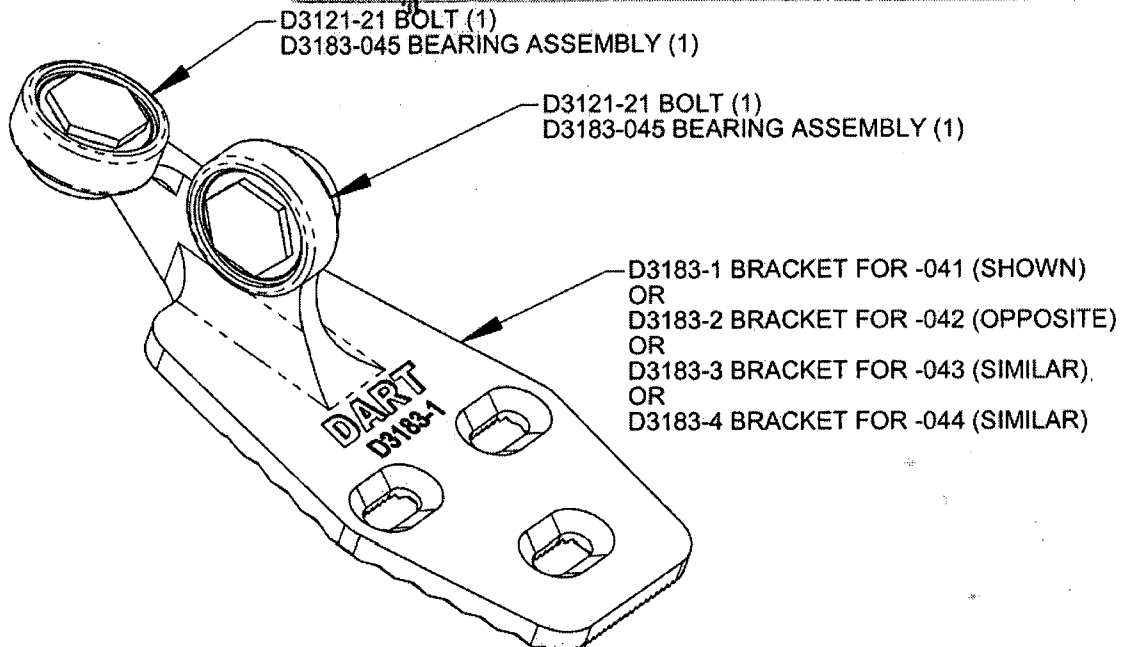


D3183-041 BRACKET ASSEMBLY (SHOWN)
D3183-042 BRACKET ASSEMBLY (OPPOSITE)
D3183-043 BRACKET ASSEMBLY (SIMILAR)
D3183-044 BRACKET ASSEMBLY (SIMILAR)

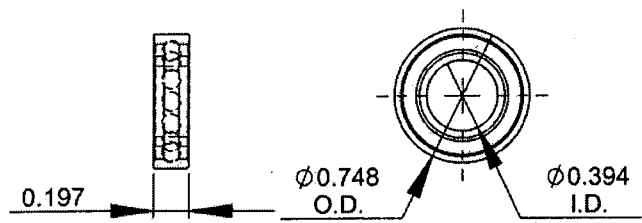

**D3183-5 BEARING:
SPECIFICATION CONTROL DRAWING**

- 1) SINGLE ROW, DEEP GROOVE, CONRAD TYPE, SHIELDED
- 2) POSSIBLE SUPPLIER: NSK P/N 6800ZZ
- 3) ALL DIMENSIONS ARE IN INCHES

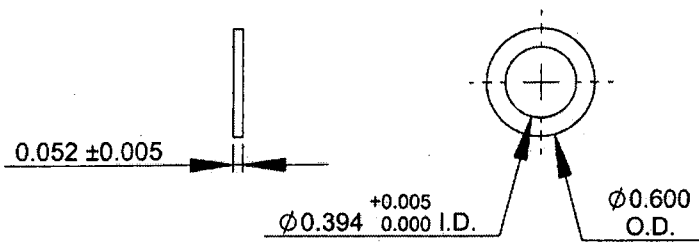

D3183-7 WASHER

- 1) MATERIAL: AISI 303 ROUND BAR (M303R) ANNEALED
- 2) BREAK ALL SHARP EDGES 0.005 TO 0.010
- 3) TOLERANCES ARE PER DART QSP0181 UNLESS OTHERWISE NOTED
- 4) ALL DIMENSIONS ARE IN INCHES

COPY
RETURN TO
ENGINEERING
CONTROLLED COPY
SUBJECT TO AMENDMENT
WITHOUT NOTICE
WORK ORDER





25551D

DART

QA COPY ISSUED

DESIGN	DRAWN BY	DART AEROSPACE LTD
CHECKED	APPROVED	HAWKESBURY, ONTARIO, CANADA
DATE	DRAWING NO.	REV. C
04.02.17	D3183	SHEET 2 OF 4
	TITLE	SCALE
	BRACKET ASSEMBLY	1:2

RELEASED
04.03.01

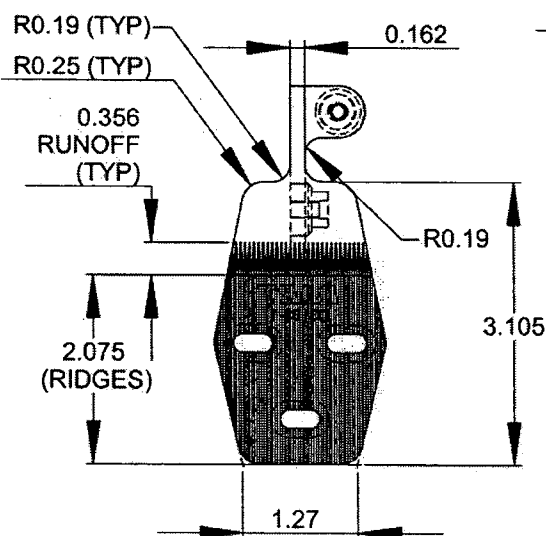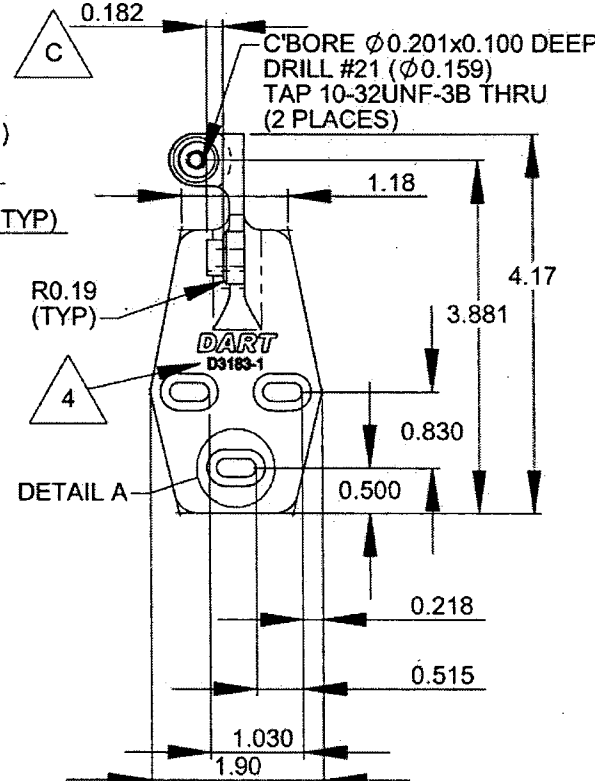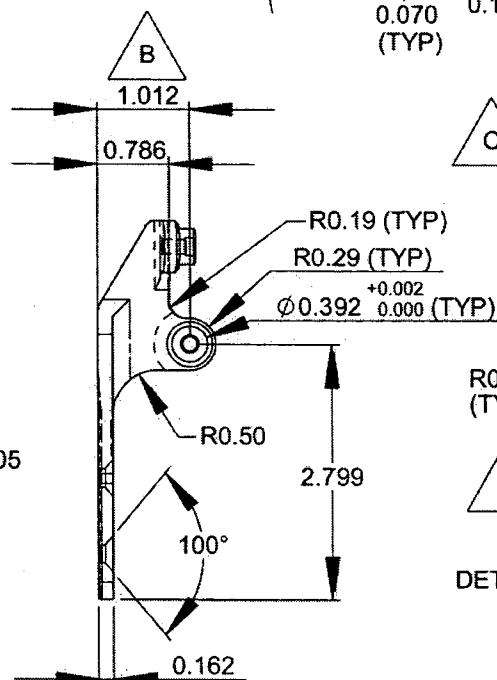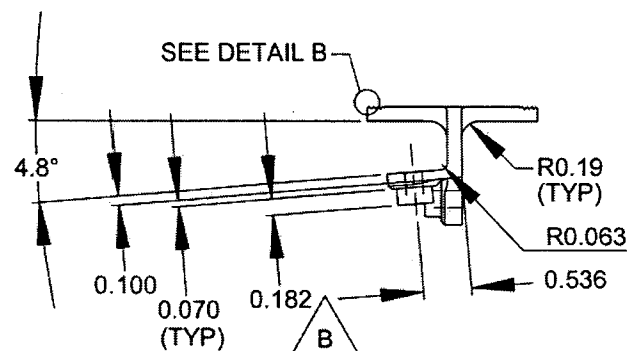

**D3183-1 BRACKET SHOWN
D3183-2 BRACKET OPPOSITE**

- 1) D3183-1 CAN BE MADE FROM D3183-3
D3183-2 CAN BE MADE FROM D3183-4
- 2) MATERIAL: M17-4 SS PER AMS 5604/5643
(REF DART SPEC. M17-4-B)
MIN ULTIMATE STRENGTH = 150 ksi
MIN YIELD STRENGTH = 100 ksi
- 3) BREAK ALL SHARP EDGES 0.005 TO 0.015
- 4) ENGRAVE DART P/N & LOGO AS SHOWN
- 5) TOLERANCES ARE PER DART QSI 018 UNLESS OTHERWISE NOTED
- 6) ALL DIMENSIONS ARE IN INCHES


COPYRIGHT © 2003 BY DART AEROSPACE LTD.

THIS DOCUMENT IS PRIVATE AND CONFIDENTIAL AND IS SUPPLIED ON THE EXPRESS CONDITION THAT IT IS NOT TO BE USED FOR ANY PURPOSE OR COPIED OR COMMUNICATED TO ANY OTHER PERSON WITHOUT WRITTEN PERMISSION FROM DART AEROSPACE LTD.

28557D

2557D

RELEASED
24-03-01

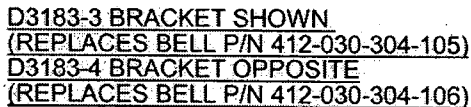





- 1) MATERIAL: 17-4 SS PER AMS 5604/5643
(REF DART SPEC. M17-4-B)
MIN ULTIMATE STRENGTH = 150 ksi
MIN YIELD STRENGTH = 100 ksi
- 2) BREAK ALL SHARP EDGES 0.005 TO 0.015
- 3) ENGRAVE DART P/N & LOGO AS SHOWN
- 4) TOLERANCES ARE PER DART QSI 018 UNLESS OTHERWISE NOTED
- 5) ALL DIMENSIONS ARE IN INCHES


DAIRT

ISSUED
OACOM

DESIGN	DRAWN BY	DART AEROSPACE LTD HAWKESBURY, ONTARIO, CANADA	
CHECKED	APPROVED	DRAWING NO.	REV. C
DATE		D3183	SHEET 3 OF 4
04.02.17		TITLE	SCALE
		BRACKET ASSEMBLY	1:2




DESIGN 	DRAWN BY 	DART AEROSPACE LTD HAWKESBURY, ONTARIO, CANADA	
CHECKED 	APPROVED 	DRAWING NO. D3183	REV. C SHEET 4 OF 4
DATE 04.02.17		TITLE BRACKET ASSEMBLY	SCALE 1:1

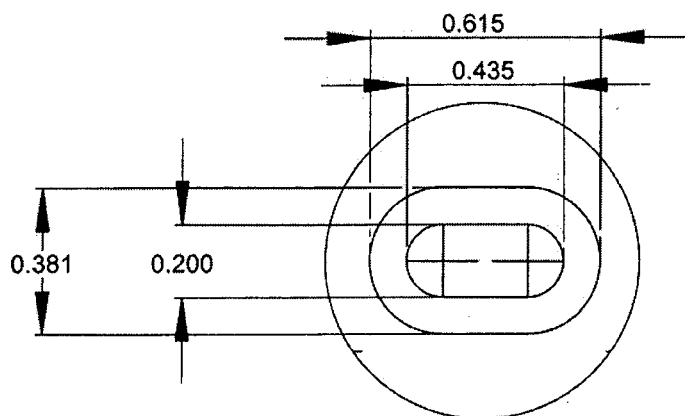


DETAIL A (2 : 1)

RELEASED
04.03.01

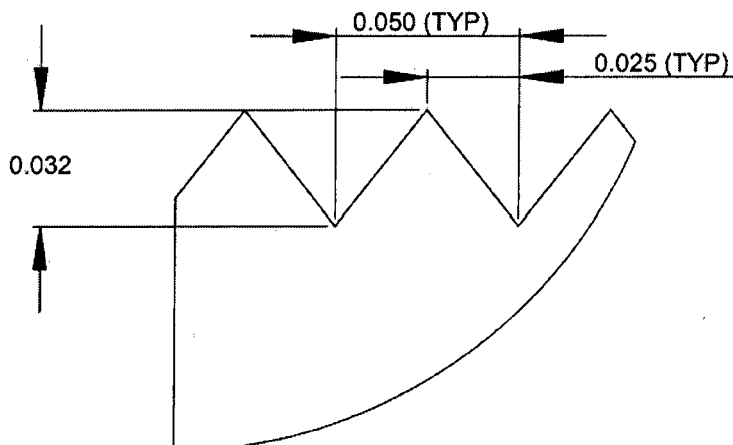

DETAIL B (20 : 1)

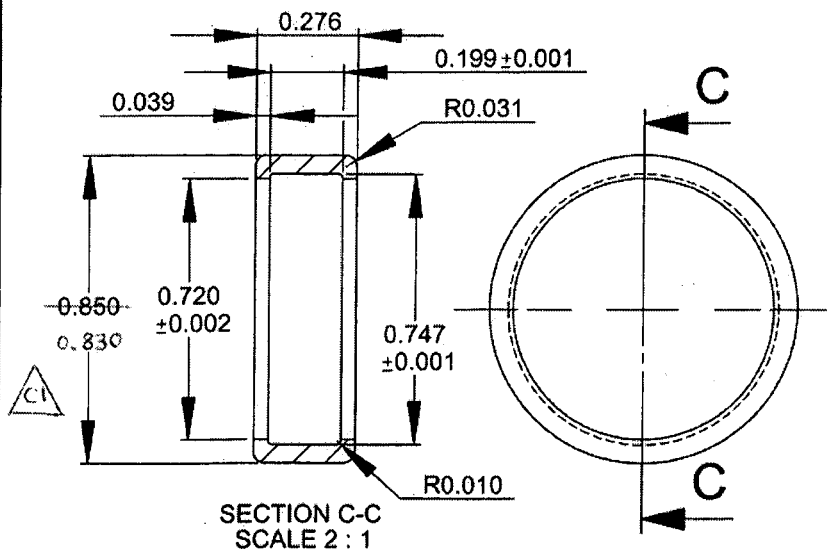

D3183-9 CAP

- 1) MATERIAL: DELRIN ROD, Ø1.00
(REF DART SPEC. M-DELRIN-R1.00)
2) TOLERANCES ARE PER DART QSI 018
UNLESS OTHERWISE NOTED
3) ALL DIMENSIONS ARE IN INCHES

D3183-045 BEARING ASSEMBLY

- 1) ASSEMBLE D3183-5 BEARING AND D3183-9 CAP

ENGINEERING

CONTROLLED COPY

TO AMENDMENT

FOIA NOTICE

COPYRIGHT © 2003 BY DART AEROSPACE LTD.

THIS DOCUMENT IS PRIVATE AND CONFIDENTIAL AND IS SUPPLIED ON THE EXPRESS CONDITION THAT IT IS NOT TO BE USED FOR ANY PURPOSE OR COPIED OR COMMUNICATED TO ANY OTHER PERSON WITHOUT WRITTEN PERMISSION FROM DART AEROSPACE LTD. 'X 10117'

NO 25557D